
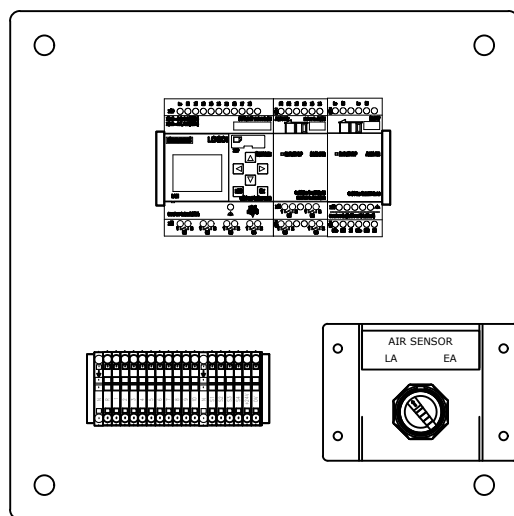


HVAC CONTROL ENCLOSURE

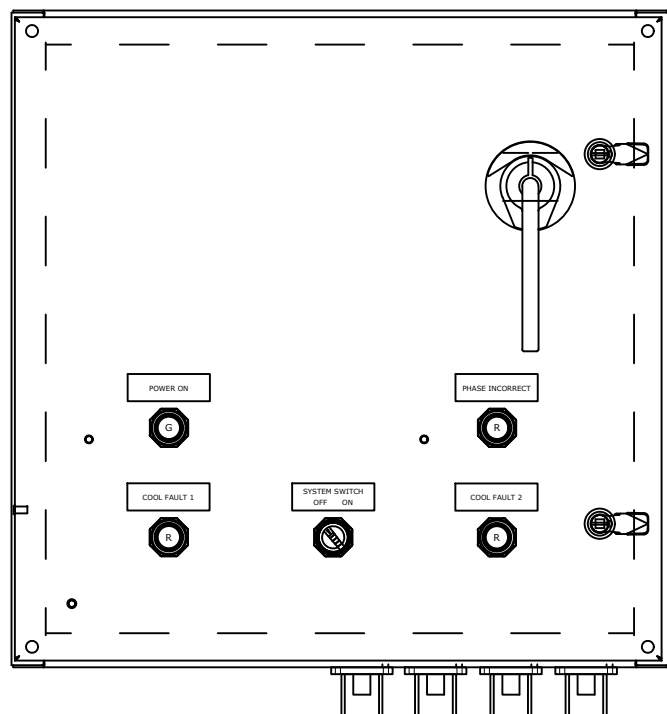

SEQUENCE OF OPERATION

The system is placed into initial operation as follows:

- Turn System Switch to "OFF"
- Turn Circuit Breaker "ON"
 - If the "Phase Incorrect" light is on, turn off the circuit breaker; reverse two (2) phases of incoming power for proper phase sequencing then check the incoming power source to be sure the unit has a good power source - 460V/3P/60HZ
 - If the "Power On" light is on and the "Phase Incorrect" light is off, the unit is ready for operation
- Turn System Switch to "ON"
- Air Sensor Switch settings:
 - 1- Leaving: The HVAC is controlled by the leaving air temperature
 - 2- Entering: The HVAC is controlled by the return air temperature
- Thermostat field settings:

Push and hold ESC and push UP or DOWN buttons to change temperature setpoint
- If a Compressor is failed, it will be turned off and locked out then its light alarm will be turned on. To clear fault, push and hold ESC and LEFT arrow
- Only use System Switch to turn off the unit

NOTE: THIS UNIT IS "COOL" ONLY

REV#	DATE	DESIGNER	DESCRIPTION
0	11/03/2017	TRUNG TRAN	ISSUE FOR CONSTRUCTION
1	01/09/2018	J.OMALLEY	ADDED NUCO DRAWINGS - ECN#00305
2	02/08/2018	TRUNG TRAN	CHANGE LOGO INPUT PER ECR# 00348
3	02/09/2018	TRUNG TRAN	CHANGE MAIN BREAKER W/MCA & MOP PER ECR# 00353
4	02/23/2018	DN/JO	AS BUILT



35 SOUTHBELT INDUSTRIAL DR., HOUSTON, TX. 77047
 PHONE: (713) 460-9009 FAX: (713) 460-9499
 TEXAS BOARD OF PROFESSIONAL ENGINEERS
 FIRM NUMBER P-14008

THIS DRAWING AND THE INFORMATION HEREIN CONTAINED ARE THE PROPERTY OF CUSTOM AIR PRODUCTS, WHICH HAS FURNISHED THEM IN CONFIDENCE UPON THE UNDERSTANDING AND CONDITION THAT ALL PERSONS, FIRMS OR CORPORATIONS RECEIVING SUCH DRAWINGS AND INFORMATION SHALL BY THE ACT OF RECEIVING THEM BE DEEMED TO HAVE AGREED: TO MAKE NO COPY, DUPLICATION, DISCLOSURE OR USE WHATSOEVER OF ALL OR ANY PART THEREOF EXCEPT AS EXPRESSLY AUTHORIZED IN WRITING BY CUSTOM AIR PRODUCTS; NOT TO GIVE, LEND OR OTHERWISE DISPOSE OF THIS DRAWING; AND TO RETURN THIS DRAWING PROMPTLY UPON REQUEST.

CERTIFIED AS-BUILT

CHECKER: _____ DATE: _____
 APPROVER: _____ DATE: _____

CAPS NO.:	DRAWING:	DRAWN BY:	DATE:
17F-0792	AE4	DAVID NGUYEN	11/09/2017
CUST. PO#:	SHEET:	CHECKED BY:	DATE:
	4 OF 4	DAVID NGUYEN	02/23/2018
SIZE:	REV:	APPROVED BY:	DATE:
B	4	LARRY NOVAK	02/23/2018

CUSTOMER:	CAPS
	40 TON INDUSTRIAL AC UNIT NEMA 4 GENERAL PURPOSE 460V/3P/60HZ ELECTRICAL DESIGN SEQUENCER OF OPERATION