


SEQUENCE OF OPERATION

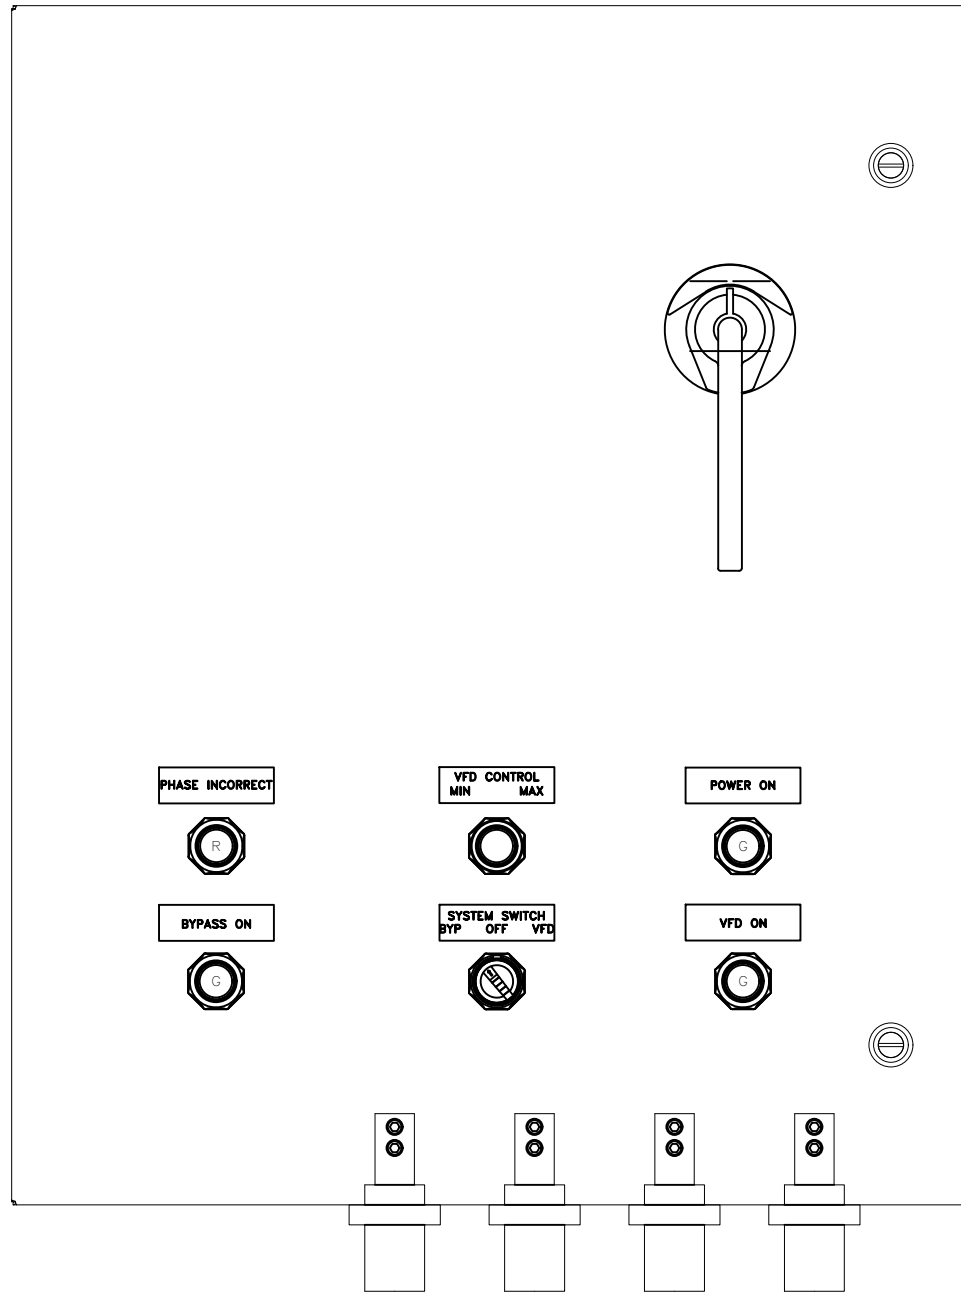


The system is placed into initial operation as follows:

- Turn System Switch to "OFF"
- Turn Circuit Breaker "ON"
 - If the "Phase Incorrect" light is on, turn off the circuit breaker; reverse two (2) phases of incoming power for proper phase sequencing then check the incoming power source to be sure the unit has a good power source - 460V/3P/60HZ
 - If the "Power On" light is on and the "Phase Incorrect" light is off, the unit is ready for operation
- Turn System Switch to position that you desire
 - 1- Bypass: The evaporator fan will bypass the VFD and runs at full speed. The "Bypass Run" light will turn on
 - 2- VFD: "VFD run" light will turn on. The evaporator fan will be controlled by the VFD. Use the POT switch to adjust evaporator fan speed.
- Only use System Switch to turn off the unit

NOTE: UNIT DOES NOT HAVE A THERMOSTAT

REV#	DATE	DESIGNER	DESCRIPTION
0	12/12/2017	TRUNG TRAN	ISSUE FOR CONSTRUCTION
1	04/27/2018	TRUNG TRAN	AS BUILT

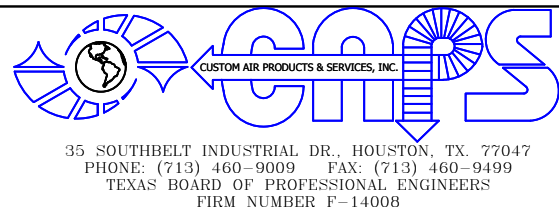

THIS DRAWING AND THE INFORMATION HEREIN CONTAINED ARE THE PROPERTY OF CUSTOM AIR PRODUCTS, WHICH HAS FURNISHED THEM IN CONFIDENCE UPON THE UNDERSTANDING AND CONDITION THAT ALL PERSONS, FIRMS OR CORPORATIONS RECEIVING SUCH DRAWINGS AND INFORMATION SHALL BY THE ACT OF RECEIVING THEM BE DEEMED TO HAVE AGREED: TO MAKE NO COPY, DUPLICATION, DISCLOSURE OR USE WHATSOEVER OF ALL OR ANY PART THEREOF EXCEPT AS EXPRESSLY AUTHORIZED IN WRITING BY CUSTOM AIR PRODUCTS; NOT TO GIVE, LEND OR OTHERWISE DISPOSE OF THIS DRAWING; AND TO RETURN THIS DRAWING PROMPTLY UPON REQUEST.

CERTIFIED AS-BUILT

CHECKER: _____ DATE: _____
 APPROVER: _____ DATE: _____

CAPS NO.: 17F-0862	DRAWING: AE4	DRAWN BY: TRUNG TRAN	DATE: 12/12/2017
CUST. PO#:	SHEET: 4 OF 5	CHECKED BY: DAVID NGUYEN	DATE: 04/27/2018
SIZE: B	REV: 1	APPROVED BY: LARRY NOVAK	DATE: 04/27/2018

CUSTOMER: HERC RENTALS
50 TON CHILLED WATER AIR HANDLING UNIT GALV SKID, GALV CAGE, COATED HOUSING DUCTED RETURN, 460V/3PH/60HZ, NEMA4 CONSTRUCTION ELECTRICAL DESIGN SEQUENCE OF OPERATION